



Allies & Ross  
Management and Development Corporation  
200 Ross Street  
Pittsburgh, PA 15219

412-456-5000

**February 2, 2023**

**Allies & Ross Management and Development Corporation**

**IFB #2023-39**

**Northview Midrise Underground Water Storage Tank**

**ADDENDUM NO. #2**

This addendum issued February 2, 2023 becomes in its entirety a part of the Invitation for Bid IFB #2023-39 as is fully set forth herein:

Item 1: Q: The Addendum #1 Item 3 states “the meter and waterlines to the meter vault and storage tank have been relocated” I am confused as to the extent of the scope of work involved. The addendum drawings have the tank, meter vault, and piping clouded out. If the vault and piping have been relocated, why is it included in the clouded work. The scope of the tank installation is not clearly defined. Can you please clearly identify the scope of work to be included?

**A: The vault, water lines, and tank were relocated from the locations shown on the original drawings issued as part of the original IFB #2023-39: drawings Dated December 10, 2021 with Revision 16 “Revised 2023/01/11.” The cloud on the drawings included as part of Addendum No. #1 show the changes from the drawings issued as part of the original IFB, not the scope. Annotated drawings C552 have been attached to this addendum. All work shown within the bubble (excavation, tank, piping, valving, vaults, back fill, etc., for a complete functioning fire tank) is the responsibility of this contractor. All other work shown outside of the bubble is by the contractors selected for IFB#2022-37. Final connections between the work in IFB #2023-39 and the work covered in IFB#2022-37 is by the contractor for IFB #2023-39.**

Item 2: Q: The scope of work section does not define the extent of work involved. Can you please clarify the scope.

**A: Annotated drawings C552 have been attached to this addendum. See also the answer to Item 1.**

Item 3: Q: If piping is to be included in the scope can you please provide the type of material. The plans do not specify the material makeup, only the sizing.

**A: All piping materials shall comply with specification Section 33 10 00 – Water Utilities and the Allegheny County Plumbing Code. Where D.I.P. is specified, it may be changed to other materials permitted by Section 33 10 00 provided it complies with and the Allegheny County Plumbing Code. All piping materials and methods should be consistent throughout the project. Do not mix materials.**

**Item 4: Routing and configuration for the fire tank filler and the building fire service has been modified. See attached annotated drawings C552 Labeled “ADDENDUM #2 ANNOTATIONS SHOWING PROJECT SCOPE FEBRUARY 02/2023” and C554 “ADDENDUM #2 UPDATED FIRE SERVICE VAULT FEBRUARY 02/2023”**

**Item 5: On Drawing FP-000: Provide two inline Armstrong 6x4LB-F Vertical In-line fire pumps, one to be standby, one to be duty. The pump shall be capable of providing 450 gpm @20 psi. The pumps shall be installed downstream of the double check valve from the tank. The pumps shall be provided with isolation valves around the pump as well as a balancing valve downstream of the pumps to be able to set the flow accordingly. Electrical work associated with the pumps shall be provided under a separate contract.**

Item 6: Is the job still bidding on 2/9/23? Please confirm.

**A: Yes, please see item 8 for confirmation and further detail.**

Item 7: Is a bidders list available that you can share with so as we would like to reach out to all interested bidders?

A: Please refer to the attached Pre-Bid attendance Sheet. Once bids are received a bidder’s list will be posted.

Item 8: The Allies & Ross Management and Development Corporation will **only be accepting physical proposals dropped off in person from 8:00 AM until the closing time of 9:00 AM on February 9, 2023** in the lobby of 100 Ross St. Pittsburgh, PA 15219. Proposals may still be submitted electronically: <https://www.dropbox.com/request/wWhVn8RP8Nr4rcHgzXOL> and may still be mailed via USPS at which time they will be Time and Date Stamped at 100 Ross Street 2nd Floor, Suite 200, Pittsburgh, PA 15219. All proposals must be received at the above address no later than February, 9 2023 at 9:00 a.m., regardless of the selected delivery mechanism.

***END OF ADDENDUM NO. #2***

*Kim Detrick*

Kim Detrick (Feb 2, 2023 15:06 EST)

Mr. Kim Detrick  
Agent

**Feb 2, 2023**

Date

# ARMDC - PRE-SUBMISSION SIGN IN SHEET - ARMDC

<u>Project Name and Number</u> ARMDC IFB #2023-39 Northview Midrise Underground Water Storage Tank		<u>Date Issued</u> January 17, 2023	<u>Due Date:</u> February 9, 2023 at 9:00AM	<u>Pre Bid Meeting</u> January 25, 2023 at 9:00 AM	
<u>Company Name</u>	<u>Company Address</u>	<u>Phone Number</u>	<u>Fax Number</u>	<u>E-Mail</u>	<u>Representative</u>
HACP Procurement	201 Kirkpatrick Street Pittsburgh, PA 15219	412-643-2900	412-456-5007	<a href="mailto:Samantha.Tirk@hacp.org">Samantha.Tirk@hacp.org</a>	Samantha Tirk
HACP Procurement	201 Kirkpatrick Street Pittsburgh, PA 15219	(412) 643-2768	412-456-5007	<a href="mailto:Renelda.Colvin@hacp.org">Renelda.Colvin@hacp.org</a>	Renelda Colvin
HACP Procurement	201 Kirkpatrick Street Pittsburgh, PA 15219	(412) 643-2869	412-456-5007	<a href="mailto:Anna.Jasim@hacp.org">Anna.Jasim@hacp.org</a>	Anna Jasim
HACP Modernization and Development	100 Ross Street 2 <sup>nd</sup> Floor Pittsburgh, PA 15219	(412) 643-2738		<a href="mailto:Jerome.Frank@hacp.org">Jerome.Frank@hacp.org</a>	Jerome Frank
HACP	2305 Bedford Avenue Pittsburgh, PA 15219	(412) 643-2835		<a href="mailto:Lloyd.Wilson@hacp.org">Lloyd.Wilson@hacp.org</a>	Lloyd Wilson
PDDM Solutions	17 E Bruceon Road Pittsburgh, PA 15236	(330) 301-8126		<a href="mailto:jbrezina@pddmsolutions.com">jbrezina@pddmsolutions.com</a>	Joel Brezina


**Project Name and Number**  
**ARMDC IFB #2023-39 Northview Midrise Underground**  
**Water Storage Tank**

**Date Issued**  
**January 17, 2023**

**Due Date:**  
**February 9, 2023 at 9:00AM**

**Pre Bid Meeting**  
**January 25, 2023 at 9:00 AM**

<b>Company Name</b>	<b>Company Address</b>	<b>Phone Number</b>	<b>Fax Number</b>	<b>E-Mail</b>	<b>Representative</b>
Fukui Architects	205 Ross Street Pittsburgh, PA 15219	(412) 281-6001		<a href="mailto:e.kento@fapc.com">e.kento@fapc.com</a>	Kento Ohmori

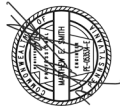

**NOTES:**

- CONTRACTOR SHALL BE RESPONSIBLE TO ADVISE TO ALL MANUFACTURERS' INSTALLATION, OPERATION, TESTING, OR OPERATION OF THE TANK SHOWN HEREIN, AND ATTENTION IMMEDIATELY.
- THE GEOTECHNICAL ENGINEER OR THEIR REPRESENTATIVE SHALL INSPECT THE EXCAVATION AND CONFIRM SOIL CONDITIONS ARE ADEQUATE FOR TANK INSTALLATION IN ACCORDANCE WITH MANUFACTURER'S RECOMMENDATIONS.
- THE MAXIMUM BURIAL DEPTH FOR STANDARD TANKS IS 7 FEET. CONTRACTOR SHALL VERIFY IF A LIAISON FROM THE TANK MANUFACTURER IS REQUIRED.
- IF THERE IS AN UNATTACHED RISER, IT MUST NOT TRANSMIT LOAD FROM THE SURFACE PAD TO THE TANK. A MINIMUM SPACE OF 6 INCHES IS REQUIRED BETWEEN THE BOTTOM OF THE RISER AND THE TOP OF THE TANK.
- SUFFICIENT CLEARANCE SHALL BE PROVIDED TO ALLOW THE BEAMER TO BE SET OUTSIDE OF THE TANK SHADOW.
- IT IS THE RESPONSIBILITY OF THE CONTRACTOR TO FOLLOW APPLICABLE REGULATIONS AND REGULATIONS PERTAINING TO SAFE EXCAVATION AND TANK INSTALLATION.
- CONTRACTOR SHALL LOCATE AND PROTECT ANY UTILITY INSTALLATIONS NEAR THE EXCAVATION BEFORE OPENING THE EXCAVATION.
- ONLY ANCHOR STRAPS AND HARDWARE PROVIDED OR OTHERWISE APPROVED BY THE TANK MANUFACTURER SHALL BE USED FOR TANK INSTALLATION.
- WHEN INSTALLING ANY SIZE TANK, AND WHEN USING MANUFACTURER'S B-RING/D-RING ANCHOR STRAPS AND PRE-FABRICATED BEAMER, THE BEAMER SHALL BE SECURED TO THE TANK MANUFACTURER'S INSTALLATION AND OPERATION GUIDELINES FOR FURTHER INFORMATION.
- CONTRACTOR SHALL COORDINATE LOCATIONS OF FILL NOZZLE AND DRAIN NOZZLE WITH TANK MANUFACTURER.
- IT IS THE RESPONSIBILITY OF THE CONTRACTOR TO COORDINATE THE TANK ASSEMBLY INCLUDING FILL NOZZLE LOCATION AND/OR FILL W/CAM CONNECTION DURING TANK ORDER WITH MANUFACTURER.

**GENERAL NOTES:**

- CONTRACTOR SHALL BE RESPONSIBLE TO ADVISE TO ALL MANUFACTURERS' INSTALLATION, OPERATION, TESTING, OR OPERATION OF THE TANK SHOWN HEREIN, AND ATTENTION IMMEDIATELY.
- THE GEOTECHNICAL ENGINEER OR THEIR REPRESENTATIVE SHALL INSPECT THE EXCAVATION AND CONFIRM SOIL CONDITIONS ARE ADEQUATE FOR TANK INSTALLATION IN ACCORDANCE WITH MANUFACTURER'S RECOMMENDATIONS.
- THE MAXIMUM BURIAL DEPTH FOR STANDARD TANKS IS 7 FEET. CONTRACTOR SHALL VERIFY IF A LIAISON FROM THE TANK MANUFACTURER IS REQUIRED.
- IF THERE IS AN UNATTACHED RISER, IT MUST NOT TRANSMIT LOAD FROM THE SURFACE PAD TO THE TANK. A MINIMUM SPACE OF 6 INCHES IS REQUIRED BETWEEN THE BOTTOM OF THE RISER AND THE TOP OF THE TANK.
- SUFFICIENT CLEARANCE SHALL BE PROVIDED TO ALLOW THE BEAMER TO BE SET OUTSIDE OF THE TANK SHADOW.
- IT IS THE RESPONSIBILITY OF THE CONTRACTOR TO FOLLOW APPLICABLE REGULATIONS AND REGULATIONS PERTAINING TO SAFE EXCAVATION AND TANK INSTALLATION.
- CONTRACTOR SHALL LOCATE AND PROTECT ANY UTILITY INSTALLATIONS NEAR THE EXCAVATION BEFORE OPENING THE EXCAVATION.
- ONLY ANCHOR STRAPS AND HARDWARE PROVIDED OR OTHERWISE APPROVED BY THE TANK MANUFACTURER SHALL BE USED FOR TANK INSTALLATION.
- WHEN INSTALLING ANY SIZE TANK, AND WHEN USING MANUFACTURER'S B-RING/D-RING ANCHOR STRAPS AND PRE-FABRICATED BEAMER, THE BEAMER SHALL BE SECURED TO THE TANK MANUFACTURER'S INSTALLATION AND OPERATION GUIDELINES FOR FURTHER INFORMATION.
- CONTRACTOR SHALL COORDINATE LOCATIONS OF FILL NOZZLE AND DRAIN NOZZLE WITH TANK MANUFACTURER.
- IT IS THE RESPONSIBILITY OF THE CONTRACTOR TO COORDINATE THE TANK ASSEMBLY INCLUDING FILL NOZZLE LOCATION AND/OR FILL W/CAM CONNECTION DURING TANK ORDER WITH MANUFACTURER.

**OWNER:**  
Allies & Ross Management and Development Corporation (ARMDC)  
200 Ross Street  
Pittsburgh, PA 15219

**CLIENT:**  
Allies & Ross Management and Development Corporation (ARMDC)  
200 Ross Street  
Pittsburgh, PA 15219

**PROJECT LOCATION:**  
Northview Heights Mallrise  
250 Penfort Street  
Pittsburgh, PA 15214

**REVISIONS:**

1	REVISED 20230209
2	REVISED 20230404
3	REVISED 20230509
4	REVISED 20230629
5	REVISED 20230823

**GENERAL NOTES:**

- CONTRACTOR SHALL BE RESPONSIBLE TO ADVISE TO ALL MANUFACTURERS' INSTALLATION, OPERATION, TESTING, OR OPERATION OF THE TANK SHOWN HEREIN, AND ATTENTION IMMEDIATELY.
- THE GEOTECHNICAL ENGINEER OR THEIR REPRESENTATIVE SHALL INSPECT THE EXCAVATION AND CONFIRM SOIL CONDITIONS ARE ADEQUATE FOR TANK INSTALLATION IN ACCORDANCE WITH MANUFACTURER'S RECOMMENDATIONS.
- THE MAXIMUM BURIAL DEPTH FOR STANDARD TANKS IS 7 FEET. CONTRACTOR SHALL VERIFY IF A LIAISON FROM THE TANK MANUFACTURER IS REQUIRED.
- IF THERE IS AN UNATTACHED RISER, IT MUST NOT TRANSMIT LOAD FROM THE SURFACE PAD TO THE TANK. A MINIMUM SPACE OF 6 INCHES IS REQUIRED BETWEEN THE BOTTOM OF THE RISER AND THE TOP OF THE TANK.
- SUFFICIENT CLEARANCE SHALL BE PROVIDED TO ALLOW THE BEAMER TO BE SET OUTSIDE OF THE TANK SHADOW.
- IT IS THE RESPONSIBILITY OF THE CONTRACTOR TO FOLLOW APPLICABLE REGULATIONS AND REGULATIONS PERTAINING TO SAFE EXCAVATION AND TANK INSTALLATION.
- CONTRACTOR SHALL LOCATE AND PROTECT ANY UTILITY INSTALLATIONS NEAR THE EXCAVATION BEFORE OPENING THE EXCAVATION.
- ONLY ANCHOR STRAPS AND HARDWARE PROVIDED OR OTHERWISE APPROVED BY THE TANK MANUFACTURER SHALL BE USED FOR TANK INSTALLATION.
- WHEN INSTALLING ANY SIZE TANK, AND WHEN USING MANUFACTURER'S B-RING/D-RING ANCHOR STRAPS AND PRE-FABRICATED BEAMER, THE BEAMER SHALL BE SECURED TO THE TANK MANUFACTURER'S INSTALLATION AND OPERATION GUIDELINES FOR FURTHER INFORMATION.
- CONTRACTOR SHALL COORDINATE LOCATIONS OF FILL NOZZLE AND DRAIN NOZZLE WITH TANK MANUFACTURER.
- IT IS THE RESPONSIBILITY OF THE CONTRACTOR TO COORDINATE THE TANK ASSEMBLY INCLUDING FILL NOZZLE LOCATION AND/OR FILL W/CAM CONNECTION DURING TANK ORDER WITH MANUFACTURER.

**GENERAL NOTES:**

- CONTRACTOR SHALL BE RESPONSIBLE TO ADVISE TO ALL MANUFACTURERS' INSTALLATION, OPERATION, TESTING, OR OPERATION OF THE TANK SHOWN HEREIN, AND ATTENTION IMMEDIATELY.
- THE GEOTECHNICAL ENGINEER OR THEIR REPRESENTATIVE SHALL INSPECT THE EXCAVATION AND CONFIRM SOIL CONDITIONS ARE ADEQUATE FOR TANK INSTALLATION IN ACCORDANCE WITH MANUFACTURER'S RECOMMENDATIONS.
- THE MAXIMUM BURIAL DEPTH FOR STANDARD TANKS IS 7 FEET. CONTRACTOR SHALL VERIFY IF A LIAISON FROM THE TANK MANUFACTURER IS REQUIRED.
- IF THERE IS AN UNATTACHED RISER, IT MUST NOT TRANSMIT LOAD FROM THE SURFACE PAD TO THE TANK. A MINIMUM SPACE OF 6 INCHES IS REQUIRED BETWEEN THE BOTTOM OF THE RISER AND THE TOP OF THE TANK.
- SUFFICIENT CLEARANCE SHALL BE PROVIDED TO ALLOW THE BEAMER TO BE SET OUTSIDE OF THE TANK SHADOW.
- IT IS THE RESPONSIBILITY OF THE CONTRACTOR TO FOLLOW APPLICABLE REGULATIONS AND REGULATIONS PERTAINING TO SAFE EXCAVATION AND TANK INSTALLATION.
- CONTRACTOR SHALL LOCATE AND PROTECT ANY UTILITY INSTALLATIONS NEAR THE EXCAVATION BEFORE OPENING THE EXCAVATION.
- ONLY ANCHOR STRAPS AND HARDWARE PROVIDED OR OTHERWISE APPROVED BY THE TANK MANUFACTURER SHALL BE USED FOR TANK INSTALLATION.
- WHEN INSTALLING ANY SIZE TANK, AND WHEN USING MANUFACTURER'S B-RING/D-RING ANCHOR STRAPS AND PRE-FABRICATED BEAMER, THE BEAMER SHALL BE SECURED TO THE TANK MANUFACTURER'S INSTALLATION AND OPERATION GUIDELINES FOR FURTHER INFORMATION.
- CONTRACTOR SHALL COORDINATE LOCATIONS OF FILL NOZZLE AND DRAIN NOZZLE WITH TANK MANUFACTURER.
- IT IS THE RESPONSIBILITY OF THE CONTRACTOR TO COORDINATE THE TANK ASSEMBLY INCLUDING FILL NOZZLE LOCATION AND/OR FILL W/CAM CONNECTION DURING TANK ORDER WITH MANUFACTURER.

**As Noted**


**Sheet No. C552**

**Project #2040**

**DATE:** December 10, 2021


**BY:**

**CHK:**

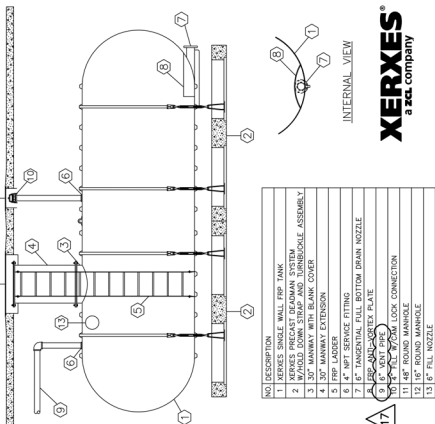

**GENERAL FIRE WATER STORAGE, FULL BOTTOM DRAIN, TANGENTIAL NOZZLE WITH ANTI-VORTEXT®**

**SEE GRAPHIC SCALE**

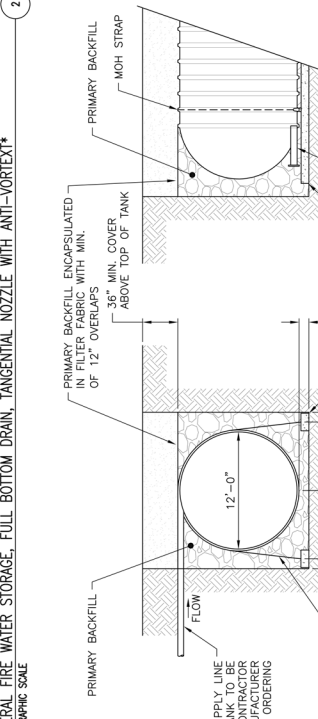

**GENERAL FIRE WATER STORAGE, FULL BOTTOM DRAIN, TANGENTIAL NOZZLE WITH ANTI-VORTEXT®**



**SEE GRAPHIC SCALE**

**GENERAL NOTES:**

- PRIMARY BACKFILL MATERIAL IS TO BE CLEAN, FREE-FLOWING, AND FREE OF DIRT, SAND, LARGE ROCKS, ROOTS, ORGANIC MATERIALS, DEBRIS, ICE AND SNOW.
- TANKS SHALL BE INSTALLED USING SELECT ROUNDED STONES OR CRUSHED STONES AS PRIMARY BACKFILL MATERIAL.
- NO BACKFILL MATERIAL SHALL BE FROZEN OR CONTAIN LUMPS OF FROZEN MATERIAL ANY TIME DURING COMPACTION OR PLACEMENT.
- USE COARSE AGGREGATE (ROUNDED STONES OR CRUSHED STONES) AS PRIMARY BACKFILL MATERIAL. SEE SIZE REQUIREMENTS FROM TANK MANUFACTURER.
- PRIMARY BACKFILL MATERIAL SHOULD BE A MIX OF WELL-SORTED STONES, GENERALLY CONFORMING TO THE 6, 6.7, 7 AND 8 SIZES OF ASTM'S C33.
- NO MORE THAN 5% OF PRIMARY BACKFILL MATERIAL SHALL PASS THE #8 SIEVE.
- MATERIALS LIKE SOFT LIMESTONE, SANDSTONE, SLAGS OR SHALE THAT BREAK DOWN OVER TIME SHALL NOT BE USED FOR TANK INSTALLATION.
- REFER TO GEOTECHNICAL RECOMMENDATIONS AND MANUFACTURER'S INSTRUCTIONS FOR BACKFILL AND COMPACTION REQUIREMENTS.
- ENCASELATE PRIMARY BACKFILL IN PENKOT CLASS 4 TYPE A GEOTEXTILE WITH A MINIMUM OVERLAP OF 12 INCHES.
- ENCASELATE BACKFILL MATERIAL UNDER EACH TANK FLANGE OR SOLID BEAMS IN ORDER TO THE TANK AND ALL SURROUNDING SHAPERS USING BACKFILL MATERIAL OTHER THAN THAT SPECIFIED HEREIN WITHOUT PRIOR WRITTEN AUTHORIZATION FROM THE TANK MANUFACTURER. YOU MAY APPLICABLE LIMITED WARRANTY.
- IT IS REQUIRED THAT THE SURFACE OF BACKFILL MATERIAL PROVIDE THE TANK INSTALLER AND TANK OWNER WITH WRITTEN CERTIFICATION THAT THE MATERIAL CONFORMS TO ASTM C 33, ASTM D 445, ASTM D 445, AND ANY OTHER APPLICABLE SPECIFICATIONS.


**GENERAL NOTES:**

- CONTRACTOR SHALL BE RESPONSIBLE TO ADVISE TO ALL MANUFACTURERS' INSTALLATION, OPERATION, TESTING, OR OPERATION OF THE TANK SHOWN HEREIN, AND ATTENTION IMMEDIATELY.
- THE GEOTECHNICAL ENGINEER OR THEIR REPRESENTATIVE SHALL INSPECT THE EXCAVATION AND CONFIRM SOIL CONDITIONS ARE ADEQUATE FOR TANK INSTALLATION IN ACCORDANCE WITH MANUFACTURER'S RECOMMENDATIONS.
- THE MAXIMUM BURIAL DEPTH FOR STANDARD TANKS IS 7 FEET. CONTRACTOR SHALL VERIFY IF A LIAISON FROM THE TANK MANUFACTURER IS REQUIRED.
- IF THERE IS AN UNATTACHED RISER, IT MUST NOT TRANSMIT LOAD FROM THE SURFACE PAD TO THE TANK. A MINIMUM SPACE OF 6 INCHES IS REQUIRED BETWEEN THE BOTTOM OF THE RISER AND THE TOP OF THE TANK.
- SUFFICIENT CLEARANCE SHALL BE PROVIDED TO ALLOW THE BEAMER TO BE SET OUTSIDE OF THE TANK SHADOW.
- IT IS THE RESPONSIBILITY OF THE CONTRACTOR TO FOLLOW APPLICABLE REGULATIONS AND REGULATIONS PERTAINING TO SAFE EXCAVATION AND TANK INSTALLATION.
- CONTRACTOR SHALL LOCATE AND PROTECT ANY UTILITY INSTALLATIONS NEAR THE EXCAVATION BEFORE OPENING THE EXCAVATION.
- ONLY ANCHOR STRAPS AND HARDWARE PROVIDED OR OTHERWISE APPROVED BY THE TANK MANUFACTURER SHALL BE USED FOR TANK INSTALLATION.
- WHEN INSTALLING ANY SIZE TANK, AND WHEN USING MANUFACTURER'S B-RING/D-RING ANCHOR STRAPS AND PRE-FABRICATED BEAMER, THE BEAMER SHALL BE SECURED TO THE TANK MANUFACTURER'S INSTALLATION AND OPERATION GUIDELINES FOR FURTHER INFORMATION.
- CONTRACTOR SHALL COORDINATE LOCATIONS OF FILL NOZZLE AND DRAIN NOZZLE WITH TANK MANUFACTURER.
- IT IS THE RESPONSIBILITY OF THE CONTRACTOR TO COORDINATE THE TANK ASSEMBLY INCLUDING FILL NOZZLE LOCATION AND/OR FILL W/CAM CONNECTION DURING TANK ORDER WITH MANUFACTURER.

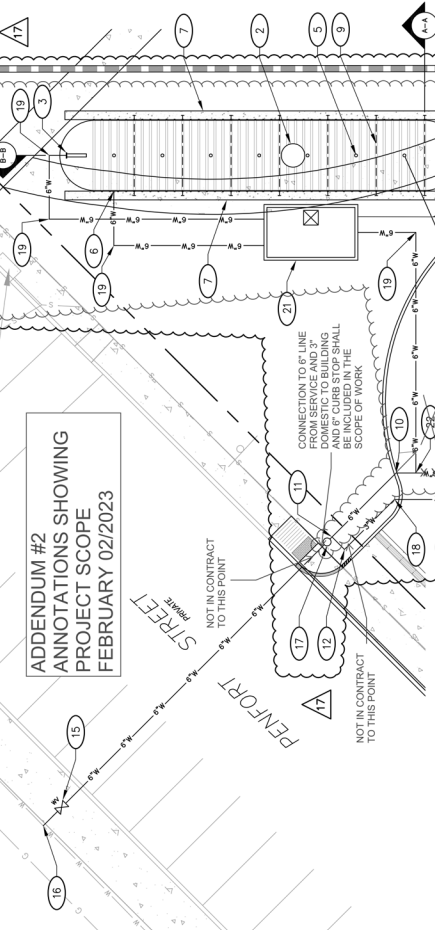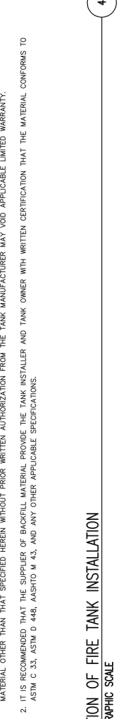

**GENERAL FIRE WATER STORAGE, FULL BOTTOM DRAIN, TANGENTIAL NOZZLE WITH ANTI-VORTEXT®**

**SEE GRAPHIC SCALE**

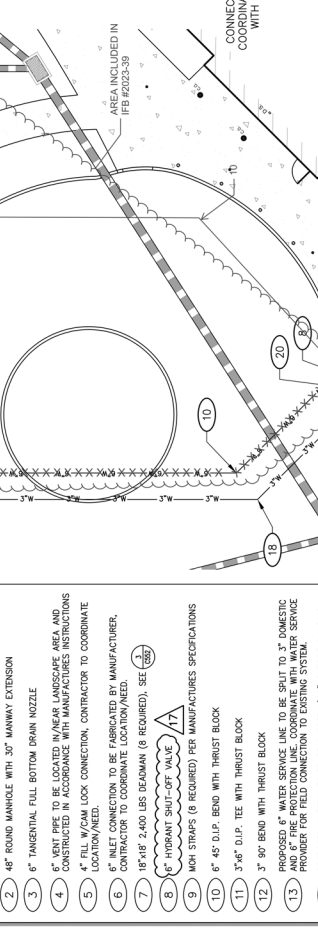


**GENERAL FIRE WATER STORAGE, FULL BOTTOM DRAIN, TANGENTIAL NOZZLE WITH ANTI-VORTEXT®**

**SEE GRAPHIC SCALE**

**GENERAL NOTES:**

- XERXES BEAMERS ARE ENGINEERED TO BE USED WITH XERXES TANKS.
- FOR CAST IN PLACE OR READY TO BE COORDINATED WITH MEP DRAWINGS SEE (68).
- XERXES INSTALLATION MANUAL AND TANK INSTALLATION AND OPERATION GUIDELINES.

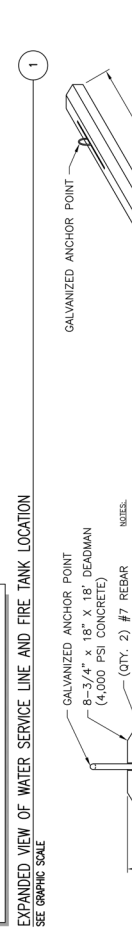


**GENERAL FIRE WATER STORAGE, FULL BOTTOM DRAIN, TANGENTIAL NOZZLE WITH ANTI-VORTEXT®**

**SEE GRAPHIC SCALE**

**GENERAL NOTES:**

- CONTRACTOR SHALL BE RESPONSIBLE TO ADVISE TO ALL MANUFACTURERS' INSTALLATION, OPERATION, TESTING, OR OPERATION OF THE TANK SHOWN HEREIN, AND ATTENTION IMMEDIATELY.
- THE GEOTECHNICAL ENGINEER OR THEIR REPRESENTATIVE SHALL INSPECT THE EXCAVATION AND CONFIRM SOIL CONDITIONS ARE ADEQUATE FOR TANK INSTALLATION IN ACCORDANCE WITH MANUFACTURER'S RECOMMENDATIONS.
- THE MAXIMUM BURIAL DEPTH FOR STANDARD TANKS IS 7 FEET. CONTRACTOR SHALL VERIFY IF A LIAISON FROM THE TANK MANUFACTURER IS REQUIRED.
- IF THERE IS AN UNATTACHED RISER, IT MUST NOT TRANSMIT LOAD FROM THE SURFACE PAD TO THE TANK. A MINIMUM SPACE OF 6 INCHES IS REQUIRED BETWEEN THE BOTTOM OF THE RISER AND THE TOP OF THE TANK.
- SUFFICIENT CLEARANCE SHALL BE PROVIDED TO ALLOW THE BEAMER TO BE SET OUTSIDE OF THE TANK SHADOW.
- IT IS THE RESPONSIBILITY OF THE CONTRACTOR TO FOLLOW APPLICABLE REGULATIONS AND REGULATIONS PERTAINING TO SAFE EXCAVATION AND TANK INSTALLATION.
- CONTRACTOR SHALL LOCATE AND PROTECT ANY UTILITY INSTALLATIONS NEAR THE EXCAVATION BEFORE OPENING THE EXCAVATION.
- ONLY ANCHOR STRAPS AND HARDWARE PROVIDED OR OTHERWISE APPROVED BY THE TANK MANUFACTURER SHALL BE USED FOR TANK INSTALLATION.
- WHEN INSTALLING ANY SIZE TANK, AND WHEN USING MANUFACTURER'S B-RING/D-RING ANCHOR STRAPS AND PRE-FABRICATED BEAMER, THE BEAMER SHALL BE SECURED TO THE TANK MANUFACTURER'S INSTALLATION AND OPERATION GUIDELINES FOR FURTHER INFORMATION.
- CONTRACTOR SHALL COORDINATE LOCATIONS OF FILL NOZZLE AND DRAIN NOZZLE WITH TANK MANUFACTURER.
- IT IS THE RESPONSIBILITY OF THE CONTRACTOR TO COORDINATE THE TANK ASSEMBLY INCLUDING FILL NOZZLE LOCATION AND/OR FILL W/CAM CONNECTION DURING TANK ORDER WITH MANUFACTURER.

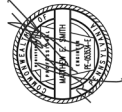

- GENERAL NOTES:**
- The contractor shall verify all dimensions and existing conditions shall be verified in the field and existing conditions shall be verified in the field.
  - Contractor shall verify all dimensions and existing conditions shall be verified in the field and existing conditions shall be verified in the field.
  - Contractor shall verify all dimensions and existing conditions shall be verified in the field and existing conditions shall be verified in the field.
  - Contractor shall be responsible for the weather, protecting materials and equipment from weather damage. No covering or protection is required to receive scheduled finishes.
REVISION	DATE	DESCRIPTION
1	REVISED 20210209	
2	REVISED 20210404	
3	REVISED 20210109	
7	REVISED 20210429	
7.1	REVISED 20210123	


**OWNER:**  
 PWSA  
 200 Ross Street  
 Pittsburgh, PA 15219

**CLIENT:**  
 Allies & Ross Management and  
 Development Corporation (ARMDC)  
 200 Ross Street  
 Pittsburgh, PA 15219


**PROJECT LOCATION:**  
 Northview Heights Midrise  
 250 Penford Street  
 Pittsburgh, PA 15214

**DRAWING TITLE:**  
 PWSA DETAILS 2 OF 2


**SHEET No.:**  
**C554**  
 Project #2040

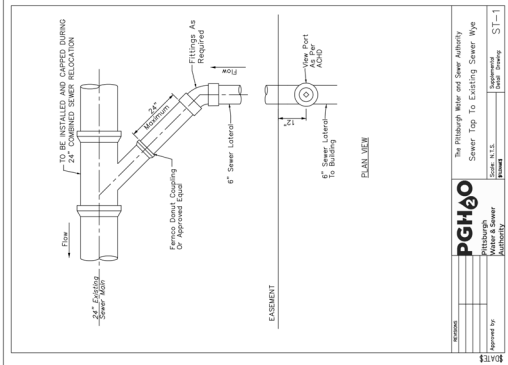


The Pittsburgh Water and Sewer Authority  
 Pittsburgh, PA 15222  
 PGH&O  
 Water & Sewer  
 Authority

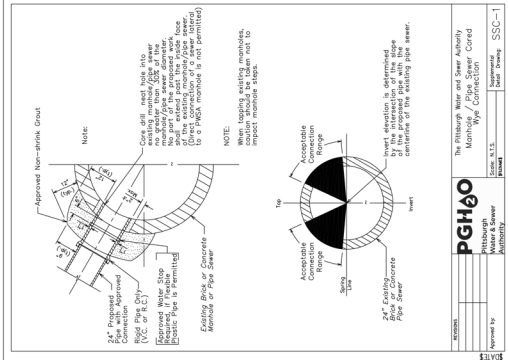


The Pittsburgh Water and Sewer Authority  
 Pittsburgh, PA 15222  
 PGH&O  
 Water & Sewer  
 Authority

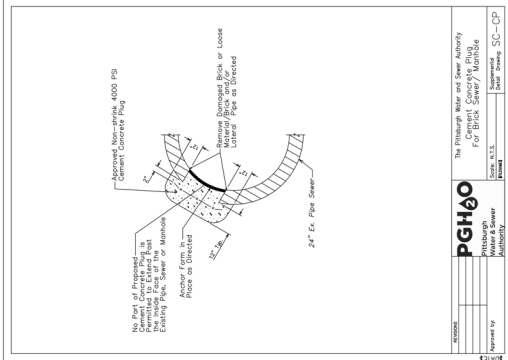

The Pittsburgh Water and Sewer Authority  
 Pittsburgh, PA 15222  
 PGH&O  
 Water & Sewer  
 Authority

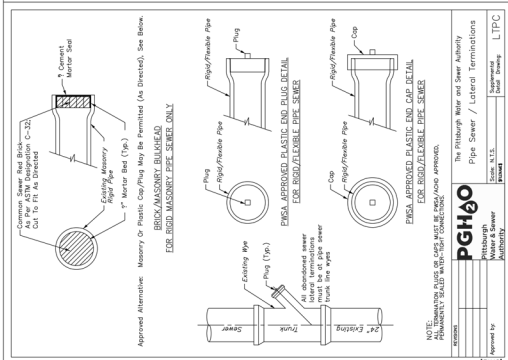

The Pittsburgh Water and Sewer Authority  
 Pittsburgh, PA 15222  
 PGH&O  
 Water & Sewer  
 Authority

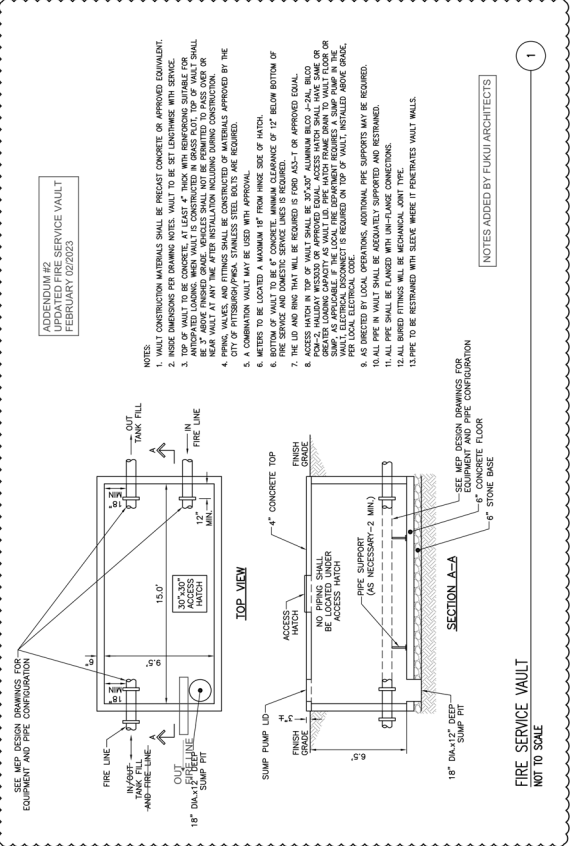

**ADDENDUM #2 SERVICE VAULT**  
 FEBRUARY 02/2023

**NOTES:**

1. VAULT CONSTRUCTION MATERIALS SHALL BE PRECAST CONCRETE OR APPROVED EQUIVALENT.
2. THE VAULT SHALL BE CONSTRUCTED TO BE AT LEAST 4" BELOW FINISH GRADE.
3. TOP OF VAULT TO BE CONCRETE AT LEAST 4" FROM FINISH GRADE. TOP OF VAULT SHALL BE CONSTRUCTED TO BE AT LEAST 4" FROM FINISH GRADE.
4. PIPING, VALVES, AND FITTINGS SHALL BE CONSTRUCTED OF MATERIALS APPROVED BY THE AUTHORITY.
5. A COMBINATION VAULT MAY BE USED WITH APPROVAL.
6. METERS TO BE LOCATED A MAXIMUM 18" FROM HINGE SIDE OF HATCH.
7. THE LID AND RING SHALL BE CONSTRUCTED TO BE AT LEAST 4" BELOW FINISH GRADE.
8. ACCESS HATCH IN TOP OF VAULT SHALL BE 30"x30" ALUMINUM BELO-J-24L BELO. BELO SHALL BE CONSTRUCTED TO BE AT LEAST 4" FROM FINISH GRADE.
9. GREATER LANDING CAPACITY AS WALLS, PIPE, HATCH FRAME DOWN TO WALL FLOOR OR HATCH FRAME SHALL BE CONSTRUCTED TO BE AT LEAST 4" FROM FINISH GRADE.
10. ALL LOCAL ELECTRICAL CODES SHALL BE OBSERVED.
11. ALL PIPE IN VAULT SHALL BE ADEQUATELY SUPPORTED AND RESTRAINED.
12. ALL BARED FITTINGS SHALL BE MECHANICAL JOINT TYPE.
13. PIPE TO BE RESTRAINED WITH SLEEVE WHERE IT PENETRATES VAULT WALLS.

**NOTES ADDED BY FUKUI ARCHITECTS**

SEE MEP DESIGN DRAWINGS FOR EQUIPMENT AND PIPE CONFIGURATION

SEE MEP PERSON DRAWINGS FOR EQUIPMENT AND PIPE CONFIGURATION

SEE MEP PERSON DRAWINGS FOR EQUIPMENT AND PIPE CONFIGURATION

SEE MEP PERSON DRAWINGS FOR EQUIPMENT AND PIPE CONFIGURATION

SEE MEP PERSON DRAWINGS FOR EQUIPMENT AND PIPE CONFIGURATION